

Prescribed Consulting For Affordable Housing Development

August 22, 2025

Mr. Rosalio Banuelos Director of Multifamily Asset Management Texas Department of Housing & Community Affairs 221 E. 11th Street Austin, TX 78701

Via Email: Rosalio.Banuelos@tdhca.texas.gov

RE: TDHCA Application #23909 / 22510 / 21039 – Uvalde Villas, McAllen, TX

Material Amendment Request

Dear Mr. Banuelos,

On behalf of TGO Uvalde 21, LP ("Applicant"), we are requesting a material amendment to the above-referenced Housing Tax Credit Applications. A check for the \$2,500 fee has been sent separately from this request. Enclosed is the receipt and copy of the check.

This amendment request is for a change to the overall development size. The reason the change is necessary is because the City of McAllen was dedicated a portion of the original site for a public road. The site plan as originally designed did not change from full Application, but the acreage determined by the As-Built survey is lower by 0.439 acres. Both the plat and the As-Built survey are attached.

This change from the original 7.393 acres to an As-Built of 6.957 acres reduces the density of units per acre by greater than 3%. There has been no change to the architectural design from Application and there are 102 units. The result is an overall reduction in density of 5.87%.

I believe that this was an oversight at Application since the road was there or was planned be there and would never have been part of the actual development site.


This change in site acreage also affects the HOME LURA and the HOME contract, along with the draft LIHTC LURA currently in process.

If you have any questions or would like to discuss these items further, please do not hesitate to contact me directly at (512) 785-3710 or via email at lora@betcohousinglab.com any time.

Sincerely,

Lora Myrick, Principal BETCO Consulting, LLC

CC via email: Jonathan Chilson; Sally Hedrick; Steve Lollis

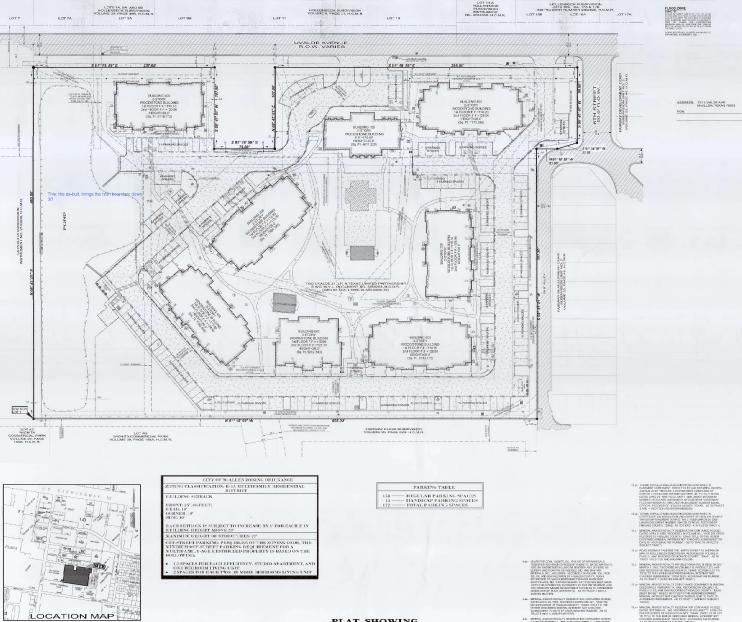

PLAT SHOWING BEING ALL OF LOT 1,
UVALDE VILLAS SUBDIVISION
INSTRUMENT No. 3489902, H.C.M.R.
CITY OF McALLEN HIDALGO COUNTY, TEXAS

crearis for ALTANSPS Land Tide Surveys, jornly established and dealthers 1, 2, 3, 4, 5, 5(a), 5(3), 7(a), 7(b), 7(c), 5, 5, 10, 1, (a), 7 Table Attractof. The fieldwork was completed on View 10, 1015.

RPLS 40: 6238

Will find of Authorities the State of the St

4 BI- THERE APPEARS TO BE NO DEDICATED ACCESS OF FECORD TO THE PROPERTY MERCEY INSURED, (TRACT 6, ONLY)

4.9. RIGHTS AND GLAMS OF OTHERSIN AND TO ANY ANDAUL IMPROVEMENTS LOCATED ON SUBJECT TRACT, (TRACT.4)

As MICHAEL STATE OF THE STATE O

Melline Amport Winn in Respective Consideration and Considera

NOTES: SURVEY IS VALID ONLY IF PRINT HAS DRIGINAL SEAL AND SQUATURE OF SURVEYOR

NORSCENT SARTHMONING WORK, BUILDINGSCONSTRUCTION, OR BUILDING ADDITIONS OSSESSIONED OFFINE TIME OF SURVEY.

NO PROPOSED CHANGES IN STREET RIGHT-CF-VAY LINES, DUFFING TIME OF SURVEY.

TIME OF SUPPLY AND THE PROPERTY OF THE PROPERT

SURVEY NAS PREMARED WITH THE BERIEFT OF CHCAGO TITLE INSURANCE COMPANY, COMMITMENT OF No. CTI-COM/CTI22710310 DATE OF POLICY: AUGUST 16, 2423

EASEMENTS LISTED IN SCHEDULE B:

OF THE ARMYS DESPREED REQUIRED.

OF THE ARMYS DESPREED THE DESPREED THE OF CT HOLLOWEDGE,
BEST VISION THE CONTROL OF THE OFFICE SHEET AND THE OFFICE SHEET A

BIOMOTECNICA SERVICE S


HOTTUDITABLE OF AN ALTERIOR AND TERMINE TO NOTICE OF A UNIVERSAL TO NOTICE OF A UNIVERSAL TO A U

JUNE 10, 1990 RECORDED BY YOU ME \$109, PAGE 56, OFFICIAL RECORDS OF HIDALDS COUNTY, TEXAS, AS TOTRACT 3 COURS NOT AFFICE SUBJECT TRACE.

Alta/ As-Built Survey

21049.21



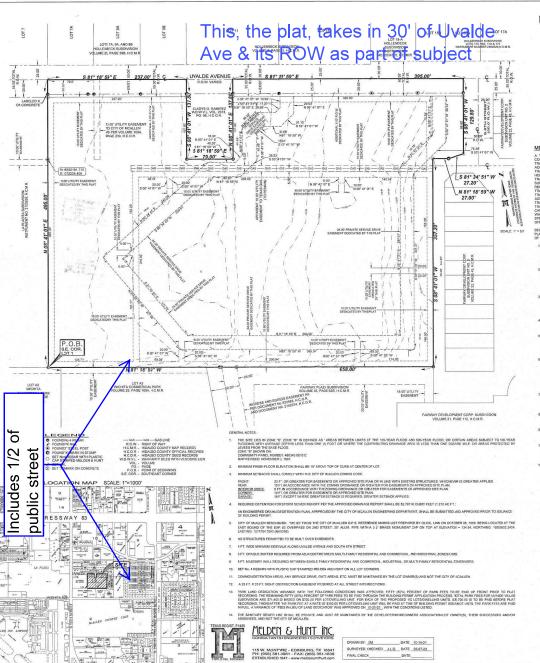

SUBDIVISION MAP OF

UVALDE VILLAS SUBDIVISION

METES AND BOUNDS DESCRIPTION:

A TRACT OF LAND CONTAINING T383 ACRES, STUATED IN THE CITY OF MCALLEN, HIDALGO COUNTY, TEXAS, CONISTING OF TRACT 10.218 OF ONE ACRE BIND THE WEST 69 FEET OF THE EAST HALF OF LOT 8, HOLLENBECK SUBDIVISION, ACCORDING TO THE PLAT THEREOF RECORDED IN VOLUME 8, PAGE 31, HOULGO COUNTY MAP RECORDS, THE THREE YES ACCOUNTY THAT PRECORDS, THE YES ACCOUNTY THAT PRECORDS ACCOUNTY THAT

BECORDS.

META'S 2.520 OF ONE ACRE BINNS THE EMSTHANFO'R PAN LOT 16, OF GAME HOLLENBECK EURONYDON.

PRATS 2.520 OF ONE ACRE BINNS THE EMSTHANFO'R PAN LOT 16, OF GAME HOLLENBECK EURONYDON.

PRATS 2.520 OF ONE ACRE BINNS THE EMSTHANFO'R LOT 12, OF BAME HOLLENBECK SUBDIVISION, BAID 0.550 OF ONE
ORD PRETARMANT OF TANDET GONLY).

PRAFT 1.080 OF OR ONE ACRE BINNS ALL OF LOTS 14 AND 18, OF BAME HOLLENBECK SUBDIVISION 7. OF SAME HOLLENBECK SUBDIVISION 7.

11. THENCE HAIT IN SY WART IT SO WIDED CALLES BY TO'S MAP CALLE AND THE WORLD THE THAT THE THAT IT SO WIDED CALLES BY TO'S MAP CALLE AND THE WORTH LINES OF SUCH FARMING WARM SUBCRISION AND WARM CONTINUED TO THE PLAT THEREOF RECORDED WARM ACCORDING TO THE PLAT THEREOF RECORDED WALLES BY AN UNLIKE SY PARKET AND SHARE OF SCENEDARY AND CONTINUED A TOTAL DETAYLOR OF SISSO FET PLAS AND A REARM FOUND. CONTINUED A TOTAL DETAYLOR OF SISSO FET PLAS AND A REARM FOUND. CONTINUED A TOTAL DETAYLOR OF SISSO FET PLAS AND A REARM FOUND. CONTINUED A TOTAL DETAYLOR OF SISSO FET PLAS AND A REARM FOUND. CONTINUED A TOTAL DETAYLOR OF SISSO FET PLAS AND A REARM FOUND. CONTINUED A TOTAL DETAYLOR OF SISSO FET PLAS AND A REARM FOUND. CONTINUED A TOTAL DETAYLOR OF SISSO FET PLAS AND A REARM FOUND. CONTINUED A TOTAL DETAYLOR OF SISSO FET PLAS AND A REARM FOUND. CONTINUED A TOTAL DETAYLOR OF SISSO FET PLAS AND A REARM FOUND. CONTINUED A TOTAL DETAYLOR OF SISSO FET PLAS AND A REARM FOUND. CONTINUED A TOTAL DETAYLOR OF SISSO FET PLAS AND A REARM FOUND. CONTINUED A TOTAL DETAYLOR OF SISSON FET PLAS AND A REARM FOUND. CONTINUED A TOTAL DETAYLOR OF SISSON FET PLAS AND A REARM FOUND. CONTINUED A TOTAL DETAYLOR OF SISSON FET TO SISSON FET PLAS AND A REARM FOUND.

COUNT OF THIS CASE. OWER OF THE LAND BROWN ON THIS PLAT, AND DESIGNATED HEREIN AS UNLINE VILLAS SUBTIVISIONS. DO THE WEDDERSON'S CONTROL OF THE WEDGE OF THE STREET'S, ALLVISY AND EXCEMPTED HEREIN AS UNLINE AND OFF THE WEDGE OF THE STREET'S, ALLVISY AND EXCEMPTED HEREIN SHOWN, SERVICE USE OF THE STREET'S, ALLVISY AND EXCEMPTED THE STREET'S, AND ALLVISY AND EXCEMPTED OF THE OWNER OF THE STREET'S, AND ALLVISY AND EXCEMPTED OF THE STREET'S, AND ALLVISY AND EXCEMPTED OF THE STREET'S AND ALLVISY AND EXCEMPTED OF THE STREET'S AND ALLVISY AND EXCEMPTED OF THE STREET'S AND ALL STREET'S AND ALLVISY AND EXCEMPTED OF THE STREET'S AND ALLVISY AND

08.30.2023

BEFORE ME. THE UNDERSIGNED AUTHORITY, ON THIS DAY PERSONALLY APPEARED <u>STEVE LOLLS.</u> KNOWN TO ME TO BE THE PERSON WHICHSE NAME IS SUBSCRIBED TO THE FORECOMO INSTRUMENT, AND ACKNOWLEDGED TO ME THAT HE EXECUTED THE PARKETED THE INFORMED AND COMPENSATIONS THREESE AND INSTRUMENT, AND ACKNOWLEDGED TO ME THAT HE EXECUTED THE

EAL OF OFFICE, THIS THE 30"DAY OF ALIA . 20 23 NOTARY PUBLIC, FOR THE STATE OF TRANS.

ANY COMMISSION EXPIRES OF THE STATE OF TRANS.



8 /30 /2023

ISONALLY APPEARED S. DAVID DEANDA JR. KNOWN TO ME TO BETTHE SETRIMENT, AND ACKNOWLEDGED TO ME THAT HE EXECUTED THE FININGER MY HAND AND.

SAME FOR THE PURPOSED AND CONSIDERATIONS THEREIN GIVEN USED AND CONSIDERATIONS THE CONSIDERATION OF CONSIDERATION OF CONSIDERATIONS THE CONSIDERATION OF CONSID





9/7/23 DATE



9-6-25



ON: 10-6-2023 4: 20 AM PW INSTRUMENT NUMBER 3489902
OF THE MAP RECORDS OF HIDALGO COUNTY

Benilda L. Deputy